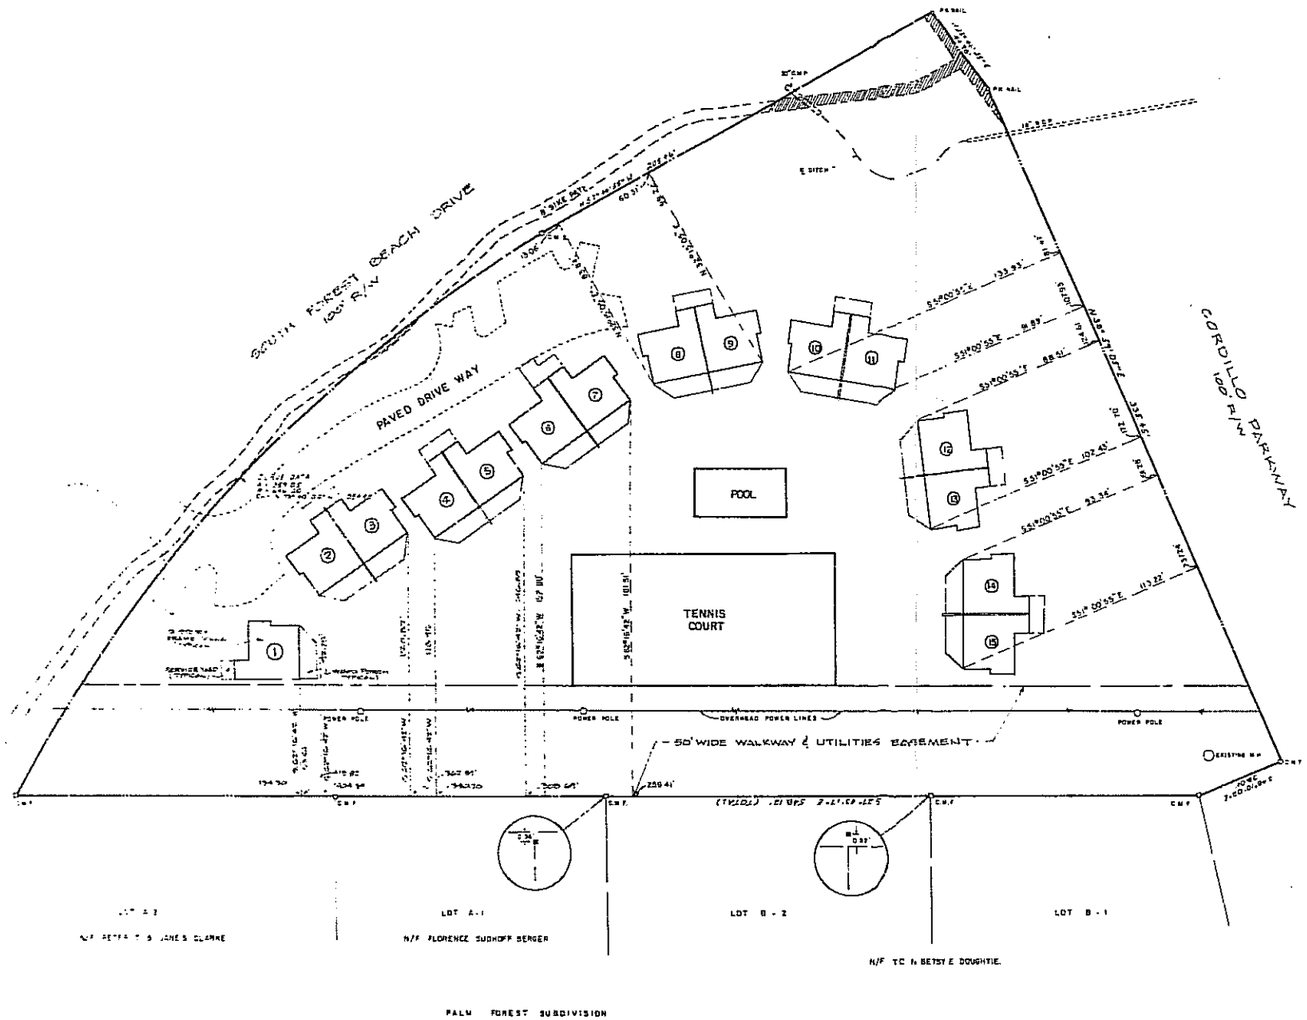

LG. PLAT FILE
PB 29 PG. 106

AREA = 2.612 ACRES

THIS PROPERTY IS LOCATED IN FIA ZONE A-15 (13.0'M.S.L.)

REFERENCE PLAT
PLAT PREPARED FOR BANKERS TRUST OCEAN GATE VILLAS 2.61 ACRE PARCEL BY FREIESLEBEN - YERKES INC DATED [illegible]

0 30 60 100 [illegible]
SCALE FEET

BENJAMIN WILSON R.L.S. S.C. [illegible]

SOUTH CAROLINA REGISTERED LAND SURVEYOR

SIE

SEA ISLAND ENGINEERING, INC.
P.O. DRAWER 1568 HILTON HEAD ISLAND, S.C. 29925
CONSULTING ENGINEERS LAND SURVEYORS
SITE PLANNERS

PREPARED FOR
SARATOGA CORPORATION
OCEAN GATE VILLAS
CORDILLO PARKWAY & SOUTH FOREST BEACH DRIVE
HILTON HEAD ISLAND, BEAUFORT COUNTY, S.C.

29100

REVISIONS

AS-BUILT SURVEY

DATE: 7/3/81

1-7

SCALE: 1" = 30'